


画地出来形確認測量図

(B N o . 3)

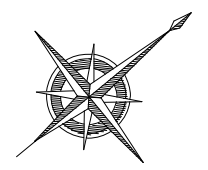

縮尺 1:500

求積表



地番 ① 3-1				
NO	X _n	Y _n	Y _{n+1} - Y _{n-1}	X _n · (Y _{n+1} - Y _{n-1})
G113	96035.517	25054.488	11.215	1077038.323155
G114	96035.527	25059.497	15.141	1454073.914307
KT16	96025.951	25069.629	1.856	178224.165056
P77	96017.214	25061.353	-21.347	-2049679.467258
P78	96029.605	25048.282	-6.865	-659243.238325
合計				413.696935
合計面積				206.8484675
地積				206.84 m ²

地番 ② 3-2				
NO	X _n	Y _n	Y _{n+1} - Y _{n-1}	X _n · (Y _{n+1} - Y _{n-1})
KT16	96025.951	25069.629	15.482	1486673.773382
G116	96019.157	25076.835	7.506	720719.792442
G117	96014.167	25077.135	-7.780	-746990.219260
P80	96004.450	25069.055	-18.509	-1776946.365050
P79	96014.341	25058.626	-7.702	-739502.454382
P77	96017.214	25061.353	11.003	1056477.405642
合計				431.932774
合計面積				215.9663870
地積				215.96 m ²

地番 ③ 3-3				
NO	X _n	Y _n	Y _{n+1} - Y _{n-1}	X _n · (Y _{n+1} - Y _{n-1})
P79	96014.341	25058.626	15.960	1532388.882360
P80	96004.450	25069.055	1.149	110309.113050
P82	95993.273	25059.775	-20.407	-1958934.722111
P81	96003.825	25048.648	-6.680	-641305.551000
P75	96008.514	25053.095	9.978	957972.952692
合計				430.674991
合計面積				215.3374955
地積				215.33 m ²

地番 ④ 3-4				
NO	X _n	Y _n	Y _{n+1} - Y _{n-1}	X _n · (Y _{n+1} - Y _{n-1})
P81	96003.825	25048.648	14.934	1433721.122550
P82	95993.273	25059.775	2.156	206961.496588
P84	95982.491	25050.804	-20.760	-1992596.513160
P83	95993.670	25039.015	-5.963	-572410.254210
P73	95999.811	25044.841	9.633	924766.179363
合計				442.031131
合計面積				221.0155655
地積				221.01 m ²

地番 ⑤ 3-5				
NO	X _n	Y _n	Y _{n+1} - Y _{n-1}	X _n · (Y _{n+1} - Y _{n-1})
P83	95993.670	25039.015	14.217	1364742.006390
P84	95982.491	25050.804	5.543	532030.947613
G103	95974.958	25044.558	-11.224	-1077222.928592
G102	95974.429	25039.580	-15.752	-1511789.205608
KT15	95982.902	25028.806	-2.993	-287276.825686
P71	95991.110	25036.587	10.209	979973.241990
合計				457.236107
合計面積				228.6180535
地積				228.61 m ²

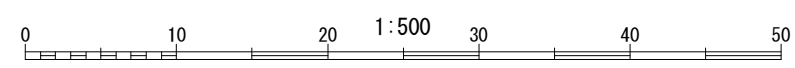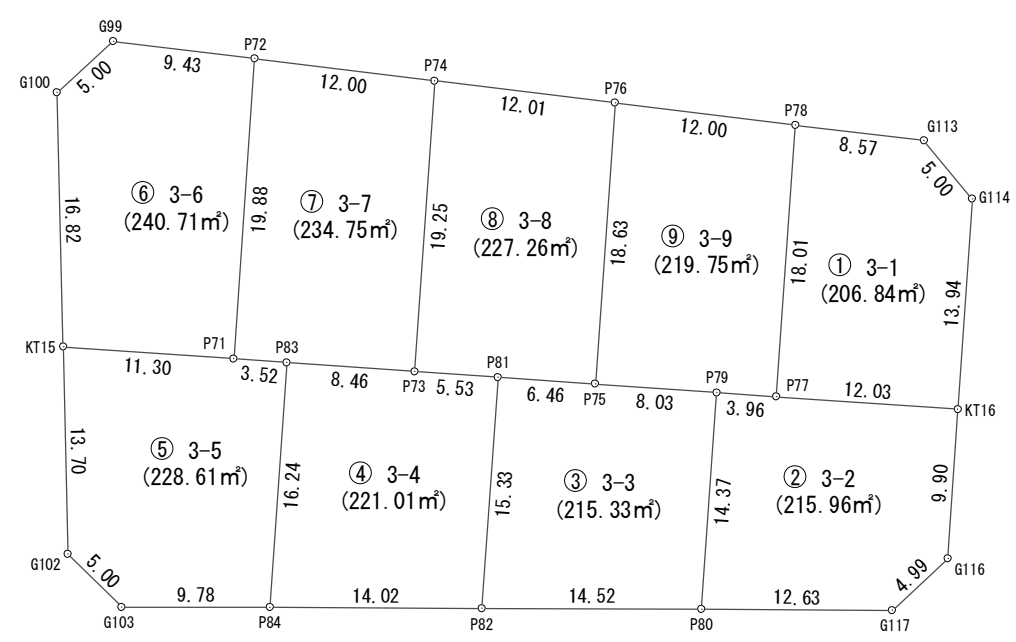

令和 4年 6月22日作成

地番 ⑥ 3-6				
NO	X_n	Y_n	$Y_{n+1} - Y_{n-1}$	$X_n \cdot (Y_{n+1} - Y_{n-1})$
P72	96004.796	25022.155	21.263	2041349.977348
P71	95991.110	25036.587	6.651	638436.872610
KT15	95982.902	25028.806	-21.018	-2017368.634236
G100	95993.289	25015.569	-13.482	-1294181.522298
G99	95998.289	25015.324	6.586	632244.731354
合計				481.424778
合計面積				240.7123890
地積				240.71 m ²

地番 ⑦ 3-7				
NO	X_n	Y_n	$Y_{n+1} - Y_{n-1}$	$X_n \cdot (Y_{n+1} - Y_{n-1})$
P74	96013.063	25030.866	22.686	2178152.347218
P73	95999.811	25044.841	8.149	782302.459839
P83	95993.670	25039.015	-8.254	-792331.752180
P71	95991.110	25036.587	-16.860	-1618410.114600
P72	96004.796	25022.155	-5.721	-549243.437916
合計				469.502361
合計面積				234.7511805
地積				234.75 m ²

地番 ⑧ 3-8				
NO	X_n	Y_n	$Y_{n+1} - Y_{n-1}$	$X_n \cdot (Y_{n+1} - Y_{n-1})$
P76	96021.337	25039.573	22.229	2134458.300173
P75	96008.514	25053.095	9.075	871277.264550
P81	96003.825	25048.648	-8.254	-792415.571550
P73	95999.811	25044.841	-17.782	-1707068.639202
P74	96013.063	25030.866	-5.268	-505796.815884
合計				454.538087
合計面積				227.2690435
地積				227.26 m ²


地番 ⑨ 3-9				
NO	X_n	Y_n	$Y_{n+1} - Y_{n-1}$	$X_n \cdot (Y_{n+1} - Y_{n-1})$
P78	96029.605	25048.282	21.780	2091524.796900
P77	96017.214	25061.353	10.344	993202.061616
P79	96014.341	25058.626	-8.258	-792886.427978
P75	96008.514	25053.095	-19.053	-1829250.217242
P76	96021.337	25039.573	-4.813	-462150.694981
合計				439.518315
合計面積				219.7591575
地積				219.75 m ²

総合計面積	2010.2777395 m ²
-------	-----------------------------


地番	面積
① 3-1	206.8484675 m ²
② 3-2	215.9663870 m ²
③ 3-3	215.3374955 m ²
④ 3-4	221.0155655 m ²
⑤ 3-5	228.6180535 m ²
⑥ 3-6	240.7123890 m ²
⑦ 3-7	234.7511805 m ²
⑧ 3-8	227.2690435 m ²
⑨ 3-9	219.7591575 m ²

画地出来形確認測量図

(B No . 4)

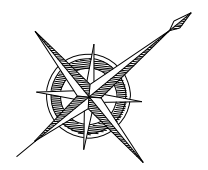

縮尺 1:500

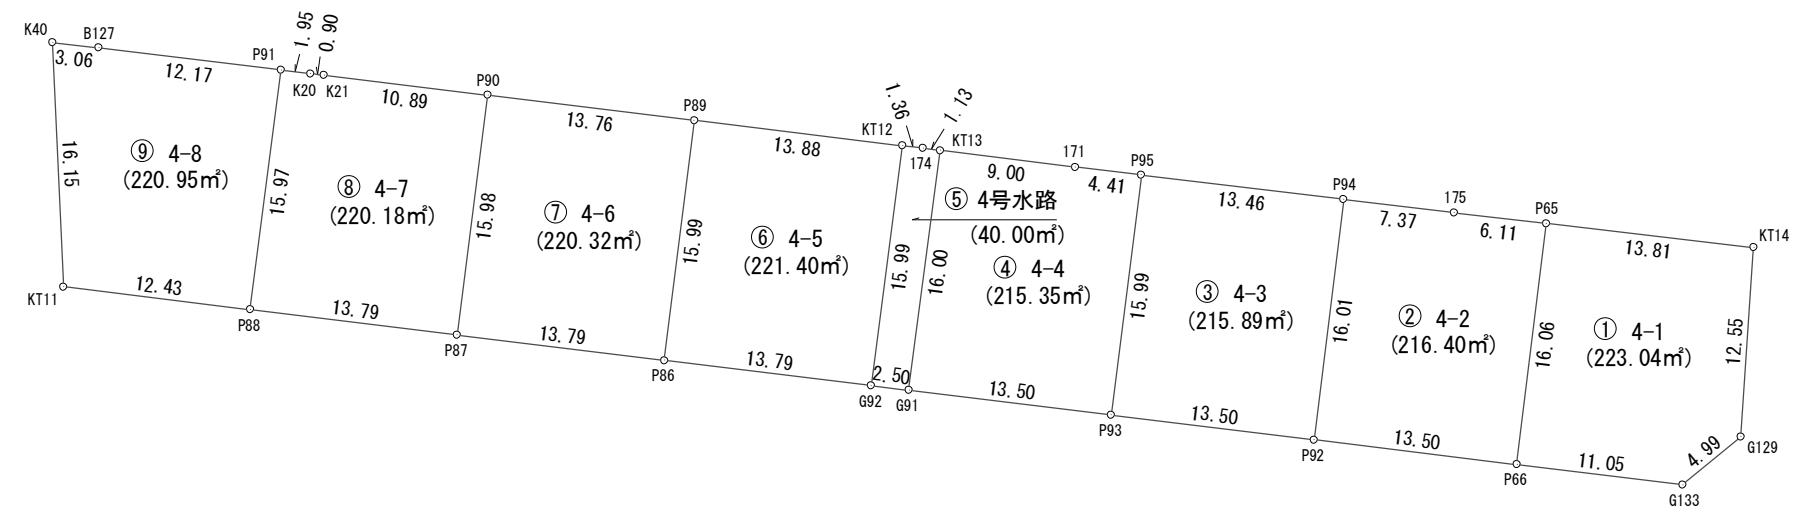

求積表

地番		① 4-1				
NO	X_n	Y_n	$Y_{n+1} - Y_{n-1}$	$X_n \cdot (Y_{n+1} - Y_{n-1})$		
P65	96043.520	25030.887	-1.118	-107376.655360		
KT14	96053.099	25040.837	19.076	1832308.916524		
G129	96044.481	25049.963	9.136	877462.378416		
G133	96039.486	25049.973	-8.008	-769084.203888		
P66	96031.874	25041.955	-19.086	-1832864.347164		
合計				446.088528		
合計面積				223.0442640		
地積				223.04	m ²	


地番		④ 4-4				
NO	X_n	Y_n	$Y_{n+1} - Y_{n-1}$	$X_n \cdot (Y_{n+1} - Y_{n-1})$		
KT13	96015.652	25001.667	-4.389	-421412.696628		
171	96021.852	25008.204	9.730	934292.619960		
P95	96024.897	25011.397	14.176	1361248.939872		
P93	96013.267	25022.380	1.196	114831.867332		
G91	96003.960	25012.593	-20.713	-1988530.023480		
合計				430.707056		
合計面積				215.3535280		
地積				215.35	m ²	

地番		② 4-2				
NO	X_n	Y_n	$Y_{n+1} - Y_{n-1}$	$X_n \cdot (Y_{n+1} - Y_{n-1})$		
P94	96034.192	25021.146	-5.689	-546338.518288		
175	96039.278	25026.480	9.741	935518.606998		
P65	96043.520	25030.887	15.475	1486273.472000		
P66	96031.874	25041.955	1.282	123112.862468		
P92	96022.568	25032.169	-20.809	-1998133.617512		
合計				432.805666		
合計面積				216.4028330		
地積				216.40	m ²	

地番		⑤ 4号水路				
NO	X_n	Y_n	$Y_{n+1} - Y_{n-1}$	$X_n \cdot (Y_{n+1} - Y_{n-1})$		
G92	96002.240	25010.778	-12.738	-1222876.533120		
KT12	96013.930	24999.855	-9.931	-953514.338830		
174	96014.874	25000.847	1.812	173978.951688		
KT13	96015.652	25001.667	11.746	1127799.848392		
G91	96003.960	25012.593	9.111	874692.079560		
合計				80.007690		
合計面積				40.0038450		
地積				40.00	m ²	

地番		③ 4-3				
NO	X_n	Y_n	$Y_{n+1} - Y_{n-1}$	$X_n \cdot (Y_{n+1} - Y_{n-1})$		
P95	96024.897	25011.397	-1.234	-118494.722898		
P94	96034.192	25021.146	20.772	1994822.236224		
P92	96022.568	25032.169	1.234	118491.848912		
P93	96013.267	25022.380	-20.772	-1994387.582124		
合計				431.780114		
合計面積				215.8900570		
地積				215.89	m ²	

地番		⑥ 4-5				
NO	X_n	Y_n	$Y_{n+1} - Y_{n-1}$	$X_n \cdot (Y_{n+1} - Y_{n-1})$		
G92	96002.240	25010.778	0.925	88802.072000		
P86	95992.734	25000.780	-20.984	-2014311.530256		
P89	96004.356	24989.794	-0.925	-88804.029300		
KT12	96013.930	24999.855	20.984	2014756.307120		
合計				442.819564		
合計面積				221.4097820		
地積				221.40	m ²	

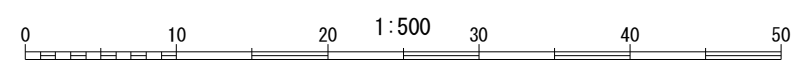


地番	⑦ 4-6			
NO	X_n	Y_n	$Y_{n+1} - Y_{n-1}$	$X_n \cdot (Y_{n+1} - Y_{n-1})$
P86	95992.734	25000.780	0.987	94744.828458
P87	95983.229	24990.781	-20.957	-2011520.530153
P90	95994.867	24979.823	-0.987	-94746.933729
P89	96004.356	24989.794	20.957	2011963.288692
		合計		440.653268
		合計面積		220.3266340
		地積		220.32 m ²

地番	⑧ 4-7			
NO	X_n	Y_n	$Y_{n+1} - Y_{n-1}$	$X_n \cdot (Y_{n+1} - Y_{n-1})$
P87	95983.229	24990.781	0.957	91855.950153
P88	95973.725	24980.780	-20.927	-2008442.143075
P91	95985.380	24969.854	-9.509	-912724.978420
K20	95986.728	24971.271	2.076	199268.447328
K21	95987.355	24971.930	8.552	820883.859960
P90	95994.867	24979.823	18.851	1809599.237817
		合計		440.373763
		合計面積		220.1868815
		地積		220.18 m ²

地番	⑨ 4-8			
NO	X_n	Y_n	$Y_{n+1} - Y_{n-1}$	$X_n \cdot (Y_{n+1} - Y_{n-1})$
P88	95973.725	24980.780	1.905	182829.946125
KT11	95965.165	24971.759	-21.952	-2106627.302080
K40	95974.854	24958.828	-10.725	-1029330.309150
B127	95976.987	24961.034	11.026	1058242.258662
P91	95985.380	24969.854	19.746	1895327.313480
		合計		441.907037
		合計面積		220.9535185
		地積		220.95 m ²

総合計面積	1793.5713430 m ²
-------	-----------------------------

地番	面積
① 4-1	223.0442640 m ²
② 4-2	216.4028330 m ²
③ 4-3	215.8900570 m ²
④ 4-4	215.3535280 m ²
⑤ 4号水路	40.0038450 m ²
⑥ 4-5	221.4097820 m ²
⑦ 4-6	220.3266340 m ²
⑧ 4-7	220.1868815 m ²
⑨ 4-8	220.9535185 m ²

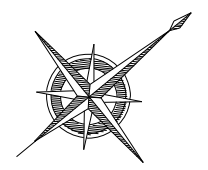

縮尺 1:500

画地出来形確認測量図

(B N o . 5)

求積表



地番 ① 5-1				
NO	X _n	Y _n	Y _{n+1} - Y _{n-1}	X _n · (Y _{n+1} - Y _{n-1})
G76	95978.757	24994.779	2.292	219983.311044
G104	95989.192	25005.761	15.983	1534195.255736
G105	95989.450	25010.762	10.335	992050.965750
P7	95985.260	25016.096	-5.729	-549899.554540
P8	95970.863	25005.033	-12.627	-1211824.087101
P10	95972.067	25003.469	-10.254	-984097.575018
合計				408.315871
合計面積				204.1579355
地積				204.15 m ²

地番 ② 5-2				
NO	X _n	Y _n	Y _{n+1} - Y _{n-1}	X _n · (Y _{n+1} - Y _{n-1})
P8	95970.863	25005.033	3.824	366992.580112
P7	95985.260	25016.096	20.108	1930071.608080
P5	95978.153	25025.141	-1.941	-186293.594973
P6	95963.855	25014.155	-12.869	-1234958.849995
P12	95965.302	25012.272	-9.122	-875395.484844
合計				416.258380
合計面積				208.1291900
地積				208.12 m ²

地番 ③ 5-3				
NO	X _n	Y _n	Y _{n+1} - Y _{n-1}	X _n · (Y _{n+1} - Y _{n-1})
P6	95963.855	25014.155	3.986	382511.926030
P5	95978.153	25025.141	20.034	1922826.317202
P3	95971.044	25034.189	-1.863	-178794.054972
P4	95956.845	25023.278	-13.034	-1250701.517730
P14	95958.477	25021.155	-9.123	-875429.185671
合計				413.484859
合計面積				206.7424295
地積				206.74 m ²

地番 ④ 5-4				
NO	X _n	Y _n	Y _{n+1} - Y _{n-1}	X _n · (Y _{n+1} - Y _{n-1})
P4	95956.845	25023.278	4.070	390544.359150
P3	95971.044	25034.189	19.966	1916157.864504
P1	95963.944	25043.244	-1.784	-171199.676096
P2	95949.839	25032.405	-13.125	-1259341.636875
P16	95951.594	25030.119	-9.127	-875750.198438
合計				410.712245
合計面積				205.3561225
地積				205.35 m ²

地番 ⑤ 5-5				
NO	X _n	Y _n	Y _{n+1} - Y _{n-1}	X _n · (Y _{n+1} - Y _{n-1})
P2	95949.839	25032.405	4.084	391859.142476
P1	95963.944	25043.244	19.893	1909010.737992
G11	95956.846	25052.298	-1.713	-164374.077198
G8	95942.834	25041.531	-13.138	-1260496.953092
P18	95944.654	25039.160	-9.126	-875590.912404
合計				407.937774
合計面積				203.9688870
地積				203.96 m ²

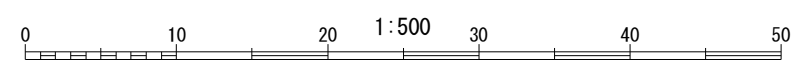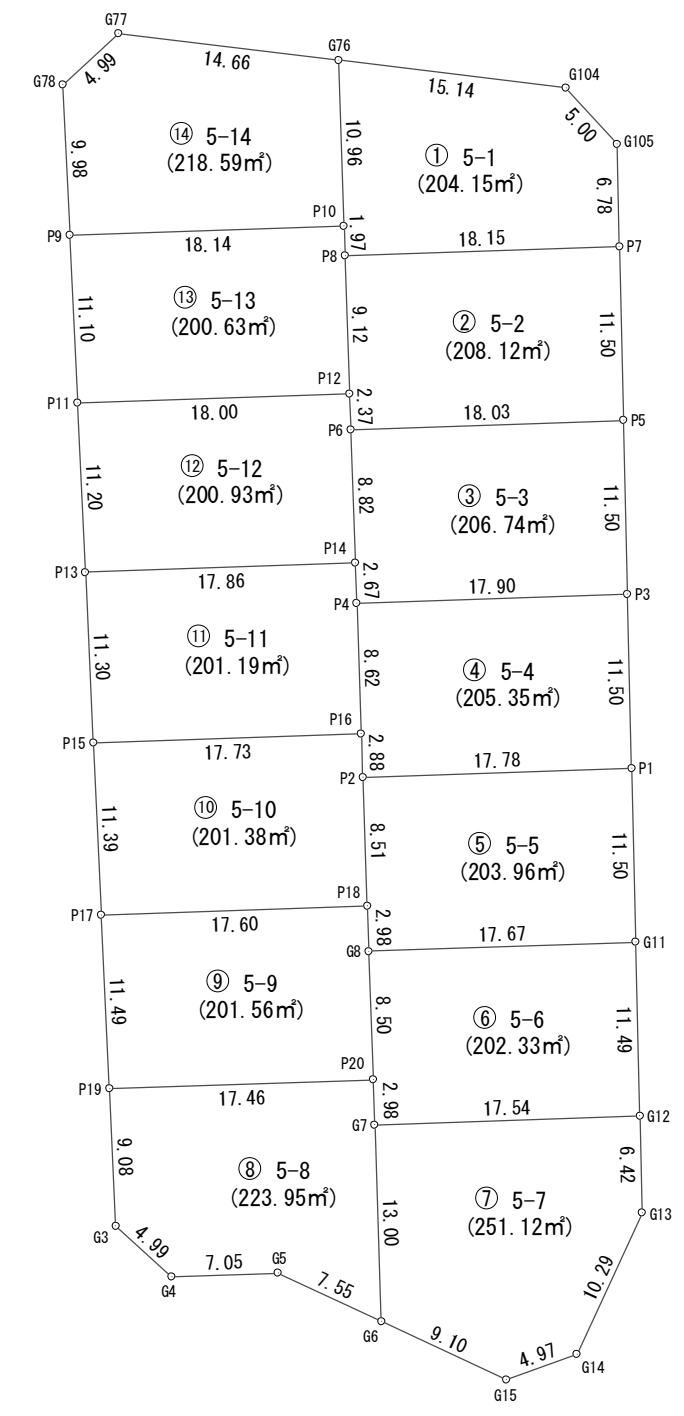

令和 4年 6月22日作成

地番 ⑥ 5-6				
NO	X _n	Y _n	Y _{n+1} -Y _{n-1}	X _n ・(Y _{n+1} -Y _{n-1})
G7	95935.834	25050.647	-13.055	-1252442.312870
P20	95937.653	25048.278	-9.116	-874567.644748
G8	95942.834	25041.531	4.020	385690.192680
G11	95956.846	25052.298	19.802	1900137.464492
G12	95949.746	25061.333	-1.651	-158413.030646
合計				404.668908
合計面積				202.3344540
地積				202.33 m ²

地番 ⑦ 5-7				
NO	X _n	Y _n	Y _{n+1} -Y _{n-1}	X _n ・(Y _{n+1} -Y _{n-1})
G7	95935.834	25050.647	0.375	35975.937750
G12	95949.746	25061.333	15.739	1510153.052294
G13	95945.783	25066.386	9.524	913787.637292
G14	95936.507	25070.857	2.795	268142.537065
G15	95931.823	25069.181	-9.899	-949629.115877
G6	95927.905	25060.958	-18.534	-1777927.791270
合計				502.257254
合計面積				251.1286270
地積				251.12 m ²

地番 ⑧ 5-8				
NO	X _n	Y _n	Y _{n+1} -Y _{n-1}	X _n ・(Y _{n+1} -Y _{n-1})
P19	95923.803	25037.636	3.369	323167.292307
P20	95937.653	25048.278	13.011	1248244.803183
G7	95935.834	25050.647	12.680	1216466.375120
G6	95927.905	25060.958	3.490	334788.388450
G5	95924.659	25054.137	-11.106	-1065339.262854
G4	95919.058	25049.852	-9.228	-885141.067224
G3	95918.354	25044.909	-12.216	-1171738.612464
合計				447.916518
合計面積				223.9582590
地積				223.95 m ²

地番 ⑨ 5-9				
NO	X _n	Y _n	Y _{n+1} -Y _{n-1}	X _n ・(Y _{n+1} -Y _{n-1})
P17	95930.696	25028.436	1.524	146198.380704
P18	95944.654	25039.160	13.095	1256395.244130
G8	95942.834	25041.531	9.118	874806.760412
P20	95937.653	25048.278	-3.895	-373677.158435
P19	95923.803	25037.636	-19.842	-1903320.099126
合計				403.127685
合計面積				201.5638425
地積				201.56 m ²

地番 ⑩ 5-10				
NO	X _n	Y _n	Y _{n+1} -Y _{n-1}	X _n ・(Y _{n+1} -Y _{n-1})
P15	95937.531	25019.313	1.683	161462.864673
P16	95951.594	25030.119	13.092	1256198.268648
P2	95949.839	25032.405	9.041	867482.494399
P18	95944.654	25039.160	-3.969	-380804.331726
P17	95930.696	25028.436	-19.847	-1903936.523512
合計				402.772482
合計面積				201.3862410
地積				201.38 m ²

地番 ⑪ 5-11				
NO	X _n	Y _n	Y _{n+1} -Y _{n-1}	X _n ・(Y _{n+1} -Y _{n-1})
P13	95944.308	25010.267	1.842	176729.415336
P14	95958.477	25021.155	13.011	1248515.744247
P4	95956.845	25023.278	8.964	860157.158580
P16	95951.594	25030.119	-3.965	-380448.070210
P15	95937.531	25019.313	-19.852	-1904551.865412
合計				402.382541
合計面積				201.1912705
地積				201.19 m ²

地番 ⑫ 5-12				
NO	X _n	Y _n	Y _{n+1} -Y _{n-1}	X _n ・(Y _{n+1} -Y _{n-1})
P11	95951.025	25001.301	2.005	192381.805125
P12	95965.302	25012.272	12.854	1233537.991908
P6	95963.855	25014.155	8.883	852446.923965
P14	95958.477	25021.155	-3.888	-373086.558576
P13	95944.308	25010.267	-19.854	-1904878.291032
合計				401.871390
合計面積				200.9356950
地積				200.93 m ²

地番 ⑬ 5-13				
NO	X _n	Y _n	Y _{n+1} -Y _{n-1}	X _n ・(Y _{n+1} -Y _{n-1})
P9	95957.681	24992.416	2.168	208036.252408
P10	95972.067	25003.469	12.617	1210879.569339
P8	95970.863	25005.033	8.803	844831.506989
P12	95965.302	25012.272	-3.732	-358142.507064
P11	95951.025	25001.301	-19.856	-1905203.552400
合計				401.269272
合計面積				200.6346360
地積				200.63 m ²

地番 ⑭ 5-14				
NO	X _n	Y _n	Y _{n+1} -Y _{n-1}	X _n ・(Y _{n+1} -Y _{n-1})
G78	95963.665	24984.429	-8.264	-793043.727560
G77	95968.648	24984.152	10.350	993275.506800
G76	95978.757	24994.779	19.317	1854021.648969
P10	95972.067	25003.469	-2.363	-226781.994321
P9	95957.681	24992.416	-19.040	-1827034.246240
合計				437.187648
合計面積				218.5938240
地積				218.59 m ²


総合計面積 2930.0814135 m²

地番	面積
① 5-1	204.1579355 m ²
② 5-2	208.1291900 m ²
③ 5-3	206.7424295 m ²
④ 5-4	205.3561225 m ²
⑤ 5-5	203.9688870 m ²
⑥ 5-6	202.3344540 m ²
⑦ 5-7	251.1286270 m ²
⑧ 5-8	223.9582590 m ²
⑨ 5-9	201.5638425 m ²
⑩ 5-10	201.3862410 m ²
⑪ 5-11	201.1912705 m ²
⑫ 5-12	200.9356950 m ²
⑬ 5-13	200.6346360 m ²
⑭ 5-14	218.5938240 m ²


令和 4年 6月22日作成

画地出来形確認測量図

(B N o . 6)

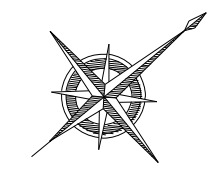

縮尺 1:500

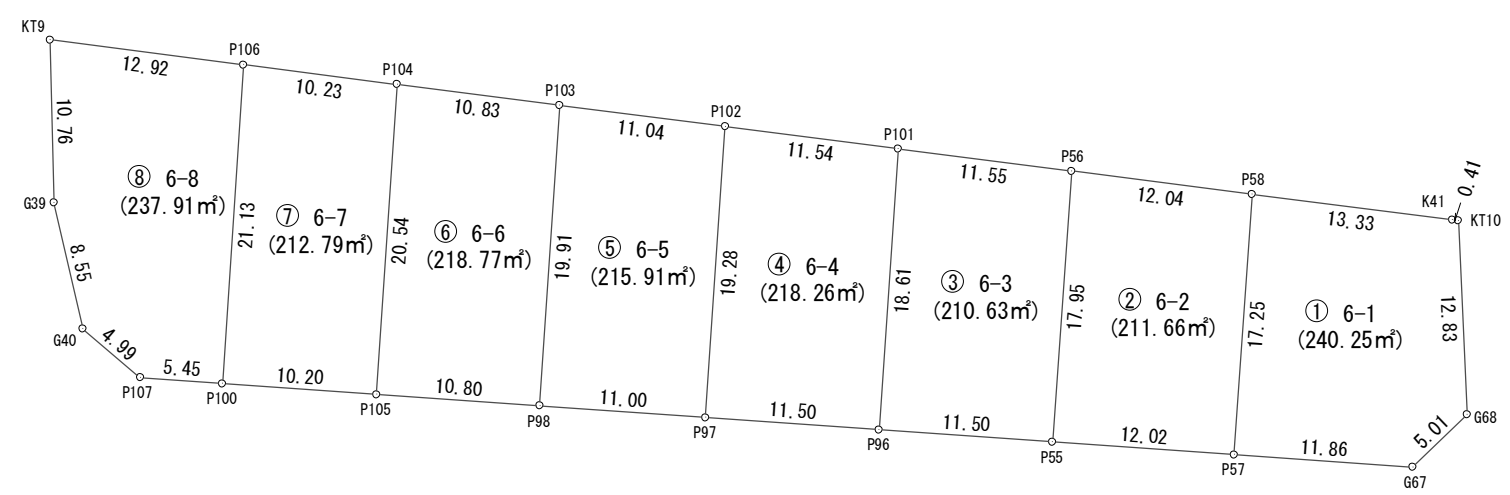


求積表

地番	① 6-1				
NO	X_n	Y_n	$Y_{n+1} - Y_{n-1}$	$X_n \cdot (Y_{n+1} - Y_{n-1})$	
G67	95932.121	25010.265	-7.777	-746064.105017	
P57	95923.518	25002.101	-20.682	-1983890.199276	
P58	95935.396	24989.583	-2.797	-268331.302612	
K41	95944.525	24999.304	10.023	961651.974075	
KT10	95944.809	24999.606	10.574	1014520.410366	
G68	95937.118	25009.878	10.659	1022593.740762	
合計				480.518298	
合計面積				240.2591490	
地積				240.25 m ²	

地番	③ 6-3				
NO	X_n	Y_n	$Y_{n+1} - Y_{n-1}$	$X_n \cdot (Y_{n+1} - Y_{n-1})$	
P55	95914.796	24993.825	5.100	489165.459600	
P96	95906.447	24985.903	-21.442	-2056426.036574	
P101	95919.245	24972.383	-5.100	-489188.149500	
P56	95927.152	24980.803	21.442	2056869.993184	
合計				421.266710	
合計面積				210.6333550	
地積				210.63 m ²	

地番	② 6-2				
NO	X_n	Y_n	$Y_{n+1} - Y_{n-1}$	$X_n \cdot (Y_{n+1} - Y_{n-1})$	
P57	95923.518	25002.101	4.242	406907.563356	
P55	95914.796	24993.825	-21.298	-2042793.325208	
P56	95927.152	24980.803	-4.242	-406922.978784	
P58	95935.396	24989.583	21.298	2043232.064008	
合計				423.323372	
合計面積				211.6616860	
地積				211.66 m ²	

地番	④ 6-4				
NO	X_n	Y_n	$Y_{n+1} - Y_{n-1}$	$X_n \cdot (Y_{n+1} - Y_{n-1})$	
P96	95906.447	24985.903	5.598	536884.290306	
P97	95898.099	24977.981	-21.939	-2103908.393961	
P102	95911.339	24963.964	-5.598	-536911.675722	
P101	95919.245	24972.383	21.939	2104372.316055	
合計				436.536678	
合計面積				218.2683390	
地積				218.26 m ²	

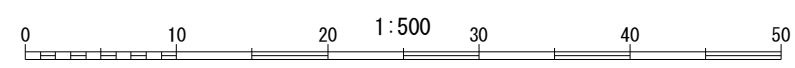

令和 4年 6月22日作成

地番		⑤ 6-5			
NO	X_n	Y_n	$Y_{n+1} - Y_{n-1}$	$X_n \cdot (Y_{n+1} - Y_{n-1})$	
P97	95898.099	24977.981	6.439	617487.859461	
P98	95890.113	24970.403	-22.067	-2116007.123571	
P103	95903.779	24955.914	-6.439	-617524.432981	
P102	95911.339	24963.964	22.067	2116475.517713	
合計				431.820622	
合計面積				215.9103110	
地積				215.91 m ²	

地番		⑥ 6-6			
NO	X_n	Y_n	$Y_{n+1} - Y_{n-1}$	$X_n \cdot (Y_{n+1} - Y_{n-1})$	
P98	95890.113	24970.403	7.050	676025.296650	
P105	95882.271	24962.964	-22.391	-2146899.929961	
P104	95896.359	24948.012	-7.050	-676069.330950	
P103	95903.779	24955.914	22.391	2147381.515589	
合計				437.551328	
合計面積				218.7756640	
地積				218.77 m ²	


地番		⑦ 6-7			
NO	X_n	Y_n	$Y_{n+1} - Y_{n-1}$	$X_n \cdot (Y_{n+1} - Y_{n-1})$	
P105	95882.271	24962.964	7.923	759675.233133	
P100	95874.867	24955.935	-22.413	-2148843.394071	
P106	95889.352	24940.551	-7.923	-759731.335896	
P104	95896.359	24948.012	22.413	2149325.094267	
合計				425.597433	
合計面積				212.7987165	
地積				212.79 m ²	

地番		⑧ 6-8			
NO	X_n	Y_n	$Y_{n+1} - Y_{n-1}$	$X_n \cdot (Y_{n+1} - Y_{n-1})$	
P100	95874.867	24955.935	11.624	1114449.454008	
P107	95870.908	24952.175	-8.678	-831967.739624	
G40	95870.038	24947.257	-12.569	-1204990.507622	
G39	95873.866	24939.606	-16.127	-1546157.836982	
KT9	95880.505	24931.130	0.945	90607.077225	
P106	95889.352	24940.551	24.805	2378535.376360	
合計				475.823365	
合計面積				237.9116825	
地積				237.91 m ²	


総合計面積	1766.2189030 m ²
-------	-----------------------------

地番	面積
① 6-1	240.2591490 m ²
② 6-2	211.6616860 m ²
③ 6-3	210.6333550 m ²
④ 6-4	218.2683390 m ²
⑤ 6-5	215.9103110 m ²
⑥ 6-6	218.7756640 m ²
⑦ 6-7	212.7987165 m ²
⑧ 6-8	237.9116825 m ²

画地出来形確認測量図 (B N o . 7)

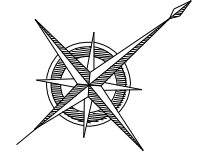

縮尺 1:500

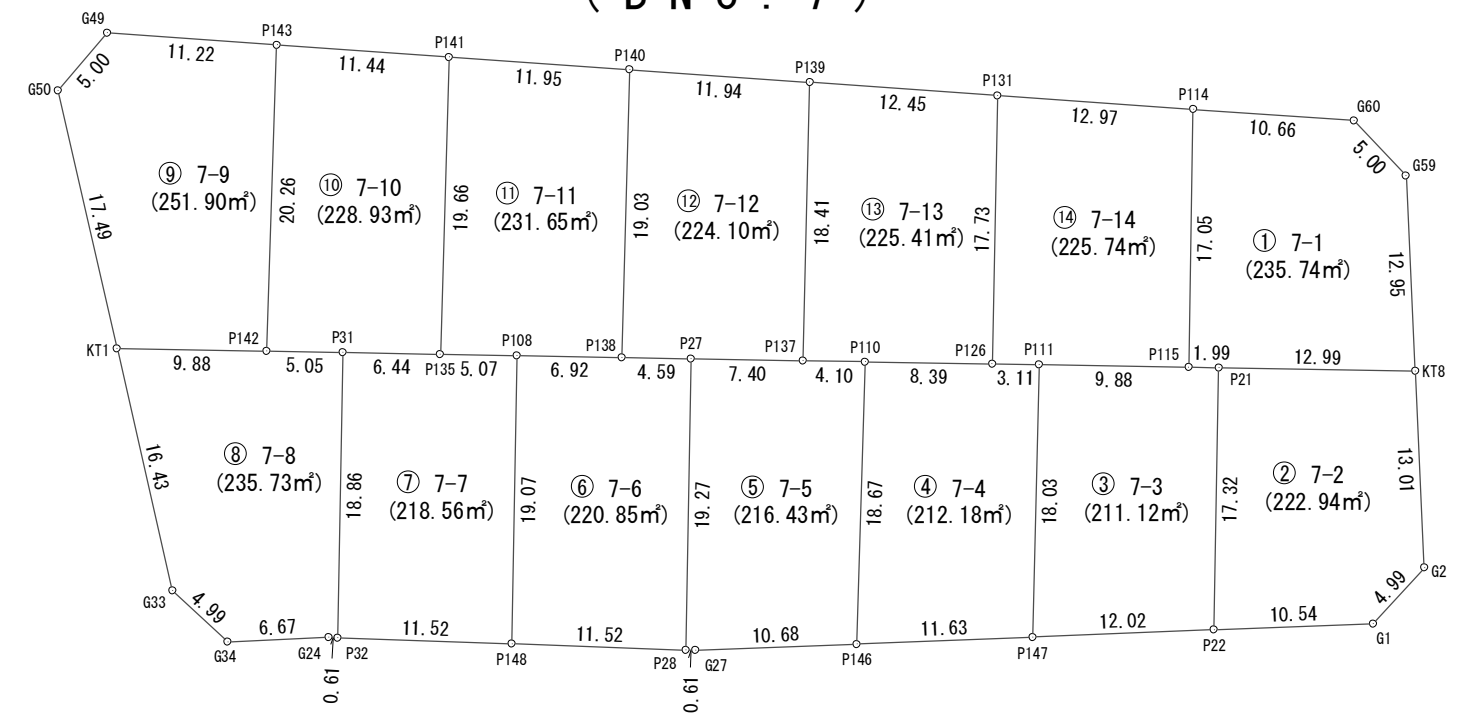

求積表

地番		① 7-1			
NO	X_n	Y_n	$Y_{n+1} - Y_{n-1}$	$X_n \cdot (Y_{n+1} - Y_{n-1})$	
P114	95921.108	25008.097	-5.638	-540803.206904	
G60	95928.852	25015.431	12.329	1182706.816308	
G59	95929.199	25020.426	15.368	1474239.930232	
KT8	95921.433	25030.799	1.939	185991.658587	
P21	95911.548	25022.365	-9.730	-933219.362040	
P115	95910.033	25021.069	-14.268	-1368444.350844	
合計				471.485339	
合計面積				235.7426695	
地積				235.74 m ²	


地番		④ 7-4			
NO	X_n	Y_n	$Y_{n+1} - Y_{n-1}$	$X_n \cdot (Y_{n+1} - Y_{n-1})$	
P110	95893.752	25007.183	-8.614	-826028.779728	
P126	95900.147	25012.626	7.460	715415.096620	
P111	95902.516	25014.643	15.656	1501449.790496	
P147	95890.716	25028.282	6.597	632591.053452	
P146	95881.454	25021.240	-21.099	-2023002.797946	
合計				424.362894	
合計面積				212.1814470	
地積				212.18 m ²	

地番		② 7-2			
NO	X_n	Y_n	$Y_{n+1} - Y_{n-1}$	$X_n \cdot (Y_{n+1} - Y_{n-1})$	
P21	95911.548	25022.365	-4.744	-455004.383712	
KT8	95921.433	25030.799	18.851	1808214.933483	
G2	95913.629	25041.216	11.133	1067806.431657	
G1	95908.690	25041.932	-5.673	-544089.998370	
P22	95900.296	25035.543	-19.567	-1876481.091832	
合計				445.891226	
合計面積				222.9456130	
地積				222.94 m ²	

地番		⑤ 7-5			
NO	X_n	Y_n	$Y_{n+1} - Y_{n-1}$	$X_n \cdot (Y_{n+1} - Y_{n-1})$	
P27	95884.996	24999.714	-9.849	-944371.325604	
P137	95890.630	25004.520	7.469	716207.115470	
P110	95893.752	25007.183	16.720	1603343.533440	
P146	95881.454	25021.240	7.593	728027.880222	
G27	95872.943	25014.776	-6.871	-658742.991353	
P28	95872.483	25014.369	-15.062	-1444031.338946	
合計				432.873229	
合計面積				216.4366145	
地積				216.43 m ²	

地番		③ 7-3			
NO	X_n	Y_n	$Y_{n+1} - Y_{n-1}$	$X_n \cdot (Y_{n+1} - Y_{n-1})$	
P111	95902.516	25014.643	-7.213	-691744.847908	
P115	95910.033	25021.069	7.722	740617.274826	
P21	95911.548	25022.365	14.474	1388223.745752	
P22	95900.296	25035.543	5.917	567442.051432	
P147	95890.716	25028.282	-20.900	-2004115.964400	
合計				422.259702	
合計面積				211.1298510	
地積				211.12 m ²	

地番		⑥ 7-6			
NO	X_n	Y_n	$Y_{n+1} - Y_{n-1}$	$X_n \cdot (Y_{n+1} - Y_{n-1})$	
P108	95876.241	24992.226	-10.003	-959050.038723	
P138	95881.504	24996.727	7.488	717960.701952	
P27	95884.996	24999.714	17.642	1691603.099432	
P28	95872.483	25014.369	7.016	672641.340728	
P148	95863.857	25006.730	-22.143	-2122713.385551	
合計				441.717838	
合計面積				220.8589190	
地積				220.85 m ²	

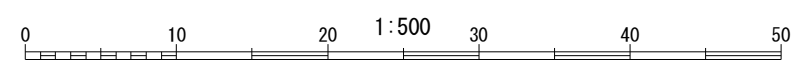

令和 4年 6月22日作成

地番		⑦ 7-7			
NO	X _n	Y _n	Y _{n+1} -Y _{n-1}	X _n ・(Y _{n+1} -Y _{n-1})	
P31	95867.481	24984.743	-10.163	-974301.209403	
P135	95872.381	24988.929	7.483	717413.027023	
P108	95876.241	24992.226	17.801	1706692.966041	
P148	95863.857	25006.730	6.866	658201.242162	
P32	95855.228	24999.092	-21.987	-2107568.898036	
合計				437.127787	
合計面積				218.5638935	
地積				218.56	m ²

地番		⑧ 7-8			
NO	X _n	Y _n	Y _{n+1} -Y _{n-1}	X _n ・(Y _{n+1} -Y _{n-1})	
KT1	95856.121	24975.036	-8.271	-792825.976791	
P142	95863.637	24981.458	9.707	930548.324359	
P31	95867.481	24984.743	17.634	1690527.159954	
P32	95855.228	24999.092	13.944	1336605.299232	
G24	95854.770	24998.687	-4.410	-422719.535700	
G34	95849.425	24994.682	-8.958	-858619.149150	
G33	95848.756	24989.729	-19.646	-1883044.660376	
合計				471.461528	
合計面積				235.7307640	
地積				235.73	m ²

地番		⑨ 7-9			
NO	X _n	Y _n	Y _{n+1} -Y _{n-1}	X _n ・(Y _{n+1} -Y _{n-1})	
G50	95863.957	24959.389	-16.507	-1582426.338199	
G49	95868.891	24958.529	6.867	658331.674497	
P143	95877.032	24966.256	22.929	2198364.466728	
P142	95863.637	24981.458	8.780	841682.732860	
KT1	95856.121	24975.036	-22.069	-2115448.734349	
合計				503.801537	
合計面積				251.9007685	
地積				251.90	m ²

地番		⑩ 7-10			
NO	X _n	Y _n	Y _{n+1} -Y _{n-1}	X _n ・(Y _{n+1} -Y _{n-1})	
P143	95877.032	24966.256	-7.322	-702011.628304	
P141	95885.333	24974.136	22.673	2174008.155109	
P135	95872.381	24988.929	10.607	1016918.345267	
P31	95867.481	24984.743	-7.471	-716225.950551	
P142	95863.637	24981.458	-18.487	-1772231.057219	
合計				457.864302	
合計面積				228.9321510	
地積				228.93	m ²

地番		⑪ 7-11			
NO	X _n	Y _n	Y _{n+1} -Y _{n-1}	X _n ・(Y _{n+1} -Y _{n-1})	
P141	95885.333	24974.136	-6.563	-629295.440479	
P140	95894.003	24982.366	22.591	2166341.421773	
P138	95881.504	24996.727	9.860	945391.629440	
P108	95876.241	24992.226	-7.798	-747642.927318	
P135	95872.381	24988.929	-18.090	-1734331.372290	
合計				463.311126	
合計面積				231.655630	
地積				231.65	m ²

地番		⑫ 7-12			
NO	X _n	Y _n	Y _{n+1} -Y _{n-1}	X _n ・(Y _{n+1} -Y _{n-1})	
P140	95894.003	24982.366	-6.136	-588405.602408	
P139	95902.668	24990.591	22.154	2124627.706872	
P137	95890.630	25004.520	9.123	874810.217490	
P27	95884.996	24999.714	-7.793	-747231.773828	
P138	95881.504	24996.727	-17.348	-1663352.331392	
合計				448.216734	
合計面積				224.1083670	
地積				224.10	m ²


地番		⑬ 7-13			
NO	X _n	Y _n	Y _{n+1} -Y _{n-1}	X _n ・(Y _{n+1} -Y _{n-1})	
P139	95902.668	24990.591	-5.354	-513462.884472	
P131	95911.701	24999.166	22.035	2113414.331535	
P126	95900.147	25012.626	8.017	768831.478499	
P110	95893.752	25007.183	-8.106	-777314.753712	
P137	95890.630	25004.520	-16.592	-1591017.332960	
合計				450.838890	
合計面積				225.4194450	
地積				225.41	m ²

地番		⑭ 7-14			
NO	X _n	Y _n	Y _{n+1} -Y _{n-1}	X _n ・(Y _{n+1} -Y _{n-1})	
P131	95911.701	24999.166	-4.529	-434384.093829	
P114	95921.108	25008.097	21.903	2100960.028524	
P115	95910.033	25021.069	6.546	627827.076018	
P111	95902.516	25014.643	-8.443	-809704.942588	
P126	95900.147	25012.626	-15.477	-1484246.575119	
合計				451.493006	
合計面積				225.7465030	
地積				225.74	m ²


総合計面積 3161.3525690 m²

地番	面積
① 7-1	235.7426695 m ²
② 7-2	222.9456130 m ²
③ 7-3	211.1298510 m ²
④ 7-4	212.1814470 m ²
⑤ 7-5	216.4366145 m ²
⑥ 7-6	220.8589190 m ²
⑦ 7-7	218.5638935 m ²
⑧ 7-8	235.7307640 m ²
⑨ 7-9	251.9007685 m ²
⑩ 7-10	228.9321510 m ²
⑪ 7-11	231.655630 m ²
⑫ 7-12	224.1083670 m ²
⑬ 7-13	225.4194450 m ²
⑭ 7-14	225.7465030 m ²

画地出来形確認測量図 (B N o . 1)

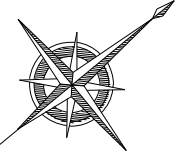

縮尺 1:500

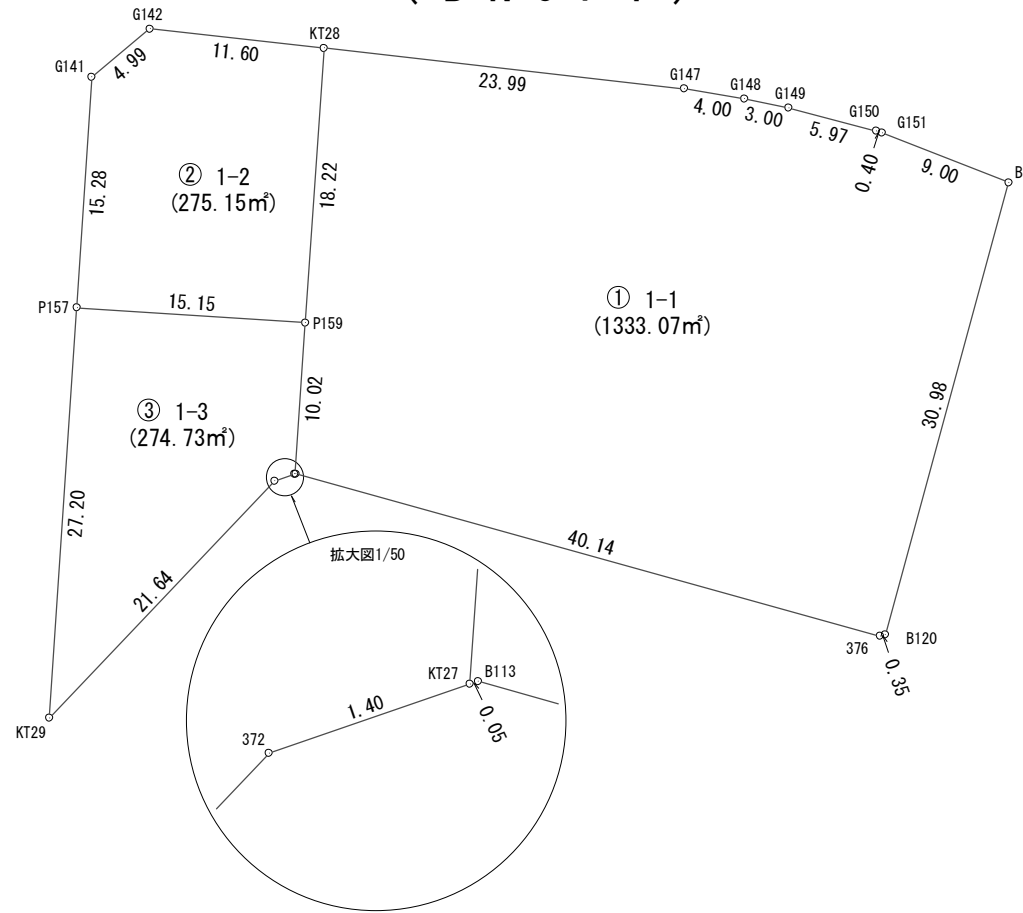

求積表


地番	① 1-1				
NO	X_n	Y_n	$Y_{n+1} - Y_{n-1}$	$X_n \cdot (Y_{n+1} - Y_{n-1})$	
KT28	96061.685	25062.615	4.007	384919.171795	
G147	96078.366	25079.861	20.265	1947028.086990	
G148	96080.997	25082.880	5.355	514513.738935	
G149	96082.885	25085.216	7.191	690932.026035	
G150	96086.376	25090.071	5.196	499264.809696	
G151	96086.593	25090.412	8.204	788294.408972	
B91	96090.981	25098.275	25.741	2473477.941921	
B120	96065.674	25116.153	17.758	1705934.238892	
376	96065.343	25116.033	-33.006	-3170732.711058	
B113	96042.326	25083.147	-32.906	-3160368.779356	
KT27	96042.272	25083.127	-7.293	-700436.289696	
P159	96049.166	25075.854	-20.512	-1970160.492992	
合計				2666.150134	
合計面積				1333.0750670	
地積				1333.07 m ²	

地番	③ 1-3				
NO	X_n	Y_n	$Y_{n+1} - Y_{n-1}$	$X_n \cdot (Y_{n+1} - Y_{n-1})$	
P157	96038.128	25065.464	-9.403	-903046.517584	
P159	96049.166	25075.854	17.663	1696516.419058	
KT27	96042.272	25083.127	6.781	651262.646432	
372	96040.955	25082.635	2.130	204567.234150	
KT29	96019.470	25085.257	-17.171	-1648750.319370	
合計				549.462686	
合計面積				274.7313430	
地積				274.73 m ²	

総合計面積 1882.9611410 m²


地番	面積
① 1-1	1333.0750670 m ²
② 1-2	275.1547310 m ²
③ 1-3	274.7313430 m ²

地番	② 1-2				
NO	X_n	Y_n	$Y_{n+1} - Y_{n-1}$	$X_n \cdot (Y_{n+1} - Y_{n-1})$	
G141	96048.600	25054.335	-11.162	-1072094.473200	
G142	96053.593	25054.302	8.280	795323.750040	
KT28	96061.685	25062.615	21.552	2070321.435120	
P159	96049.166	25075.854	2.849	273644.073934	
P157	96038.128	25065.464	-21.519	-2066644.476432	
合計				550.309462	
合計面積				275.1547310	
地積				275.15 m ²	

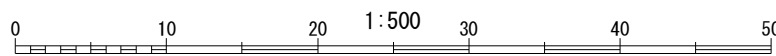


令和 4年 6月22日作成

画地出来形確認測量図 (B N o . 2 の 一 部)

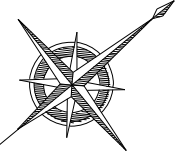

縮尺 1:500

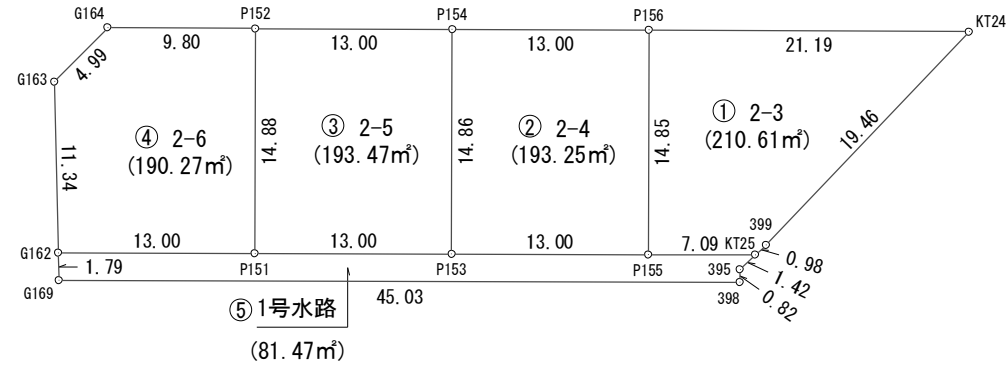

求積表

地 番 ① 2-3					
NO	X _n	Y _n	Y _{n+1} - Y _{n-1}	X _n · (Y _{n+1} - Y _{n-1})	
P156	95998.894	25072.225	2.114	202941.661916	
KT24	96015.184	25085.780	15.912	1527793.607808	
399	95995.865	25088.137	2.416	231926.009840	
KT25	95994.881	25088.196	-4.471	-429193.112951	
P155	95989.414	25083.666	-15.971	-1533046.930994	
合 計				421.235619	
合 計 面 積				210.6178095	
地 積				210.61 m ²	

地 番 ⑤ 1号水路					
NO	X _n	Y _n	Y _{n+1} - Y _{n-1}	X _n · (Y _{n+1} - Y _{n-1})	
G169	95958.270	25060.193	-30.153	-2893429.715310	
G162	95959.374	25058.776	6.881	660296.452494	
P151	95969.386	25067.074	16.594	1592515.991284	
P153	95979.401	25075.370	16.592	1592490.221392	
P155	95989.414	25083.666	12.826	1231160.223964	
KT25	95994.881	25088.196	4.615	443016.375815	
395	95993.454	25088.281	0.733	70363.201782	
398	95992.944	25088.929	-28.088	-2696249.811072	
合 計				162.940349	
合 計 面 積				81.4701745	
地 積				81.47 m ²	


総計面積	869.0957495 m ²
------	----------------------------

地 番	面 積
① 2-3	210.6178095 m ²
② 2-4	193.2570020 m ²
③ 2-5	193.4712520 m ²
④ 2-6	190.2795115 m ²
⑤ 1号水路	81.4701745 m ²

地 番 ② 2-4					
NO	X _n	Y _n	Y _{n+1} - Y _{n-1}	X _n · (Y _{n+1} - Y _{n-1})	
P154	95988.885	25063.923	-3.145	-301885.043325	
P156	95998.894	25072.225	19.743	1895306.164242	
P155	95989.414	25083.666	3.145	301886.707030	
P153	95979.401	25075.370	-19.743	-1894921.313943	
合 計				386.514004	
合 計 面 積				193.2570020	
地 積				193.25 m ²	

地 番 ③ 2-5					
NO	X _n	Y _n	Y _{n+1} - Y _{n-1}	X _n · (Y _{n+1} - Y _{n-1})	
P152	95978.886	25055.609	-3.151	-302429.469786	
P154	95988.885	25063.923	19.761	1896836.356485	
P153	95979.401	25075.370	3.151	302431.092551	
P151	95969.386	25067.074	-19.761	-1896451.036746	
合 計				386.942504	
合 計 面 積				193.4712520	
地 積				193.47 m ²	

地 番 ④ 2-6					
NO	X _n	Y _n	Y _{n+1} - Y _{n-1}	X _n · (Y _{n+1} - Y _{n-1})	
G163	95966.382	25049.856	-9.439	-905826.679698	
G164	95971.353	25049.337	5.753	552123.193809	
P152	95978.886	25055.609	17.737	1702377.500982	
P151	95969.386	25067.074	3.167	303935.045462	
G162	95959.374	25058.776	-17.218	-1652228.501532	
合 計				380.559023	
合 計 面 積				190.2795115	
地 積				190.27 m ²	

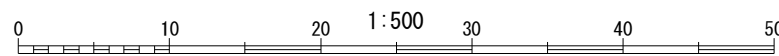

令和 4年 6月22日作成